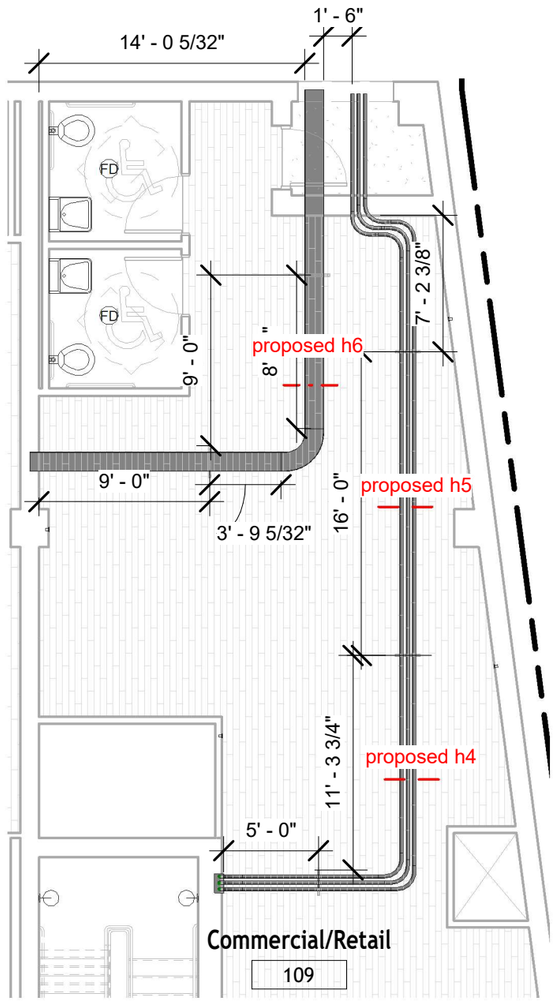


1 FC-01-Rack Support Layout Review
1/8" = 1'-0"

SUPPORT PLACEMENT NOTES — SIMULATED CHANGE

FC-01 — REVISE RACEWAY SUPPORT LAYOUT

1. Proposed locations are approximate. Dimension final support locations in the revised drawings.
2. Measure hanger spacing center-to-center.
3. Secure EMT at intervals not exceeding 10'-0" and within 3'-0" of boxes and terminations.
4. Cable-tray straight-run spacing: 5'-0" maximum provisional target; verify against manufacturer load/span requirements.
5. For the 90° tray elbow, provide supports within 2'-0" of each fitting end and at the midpoint of the curve, unless manufacturer instructions differ.
6. Coordinate supports with structure and adjacent services. Update affected drawings and support quantities.

AFFECTED OUTPUTS: E101, E103, IS1.01, PF1.01 AND MTO-01.

AUTODESK

www.autodesk.com/revit

Isaak Meakin

ST Electrical

No.	Description	Date

Supports - Proposed Change

Project number	ST-001	FC-01
Date	10/8/26	
Drawn by	Author	
Checked by	Checker	Scale 1/8" = 1'-0"

10/13/2026 10:45:16 PM